
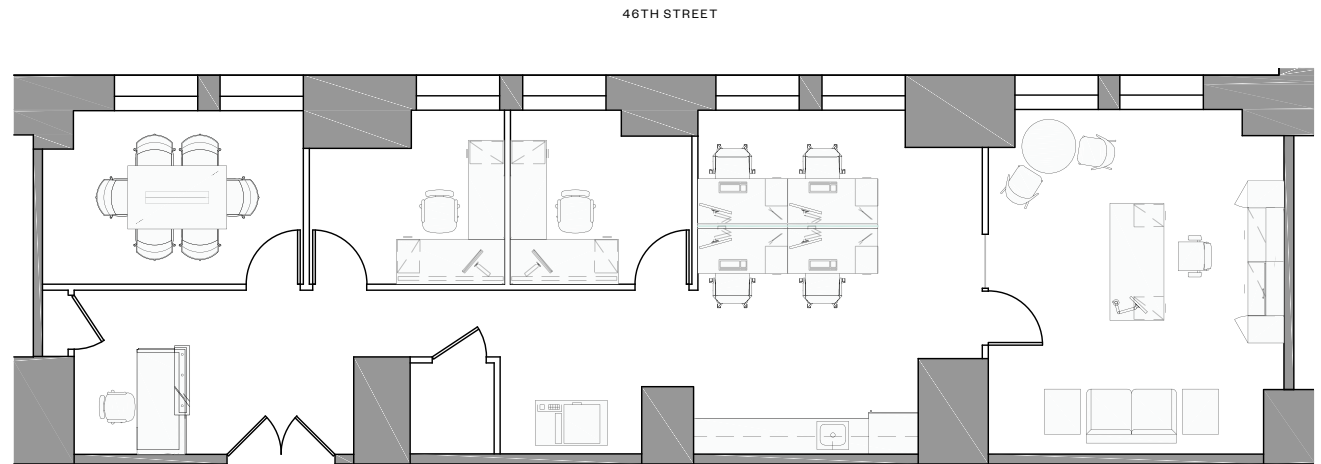


THE
HELMSLEY
BUILDING
230 PARK AVENUE

SUITE 922

As-Built

Private Office	3
Workstations	4
Conference Room	1
IT Room	1
Pantry / Cafe	1
Copy Area	1
Reception	1
<hr/>	
Total Seats	8

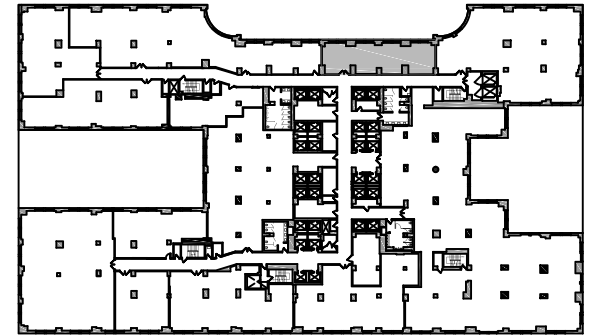

Jordan Berger
jberger@rxrrealty.com
646 891 3524

HelmsleyBuilding.com





THE
HELMSLEY
BUILDING
230 PARK AVENUE

SUITE 922

As-Built

Private Office	3
Workstations	4
Conference Room	1
IT Room	1
Pantry / Cafe	1
Copy Area	1
Reception	1
<hr/>	
Total Seats	8

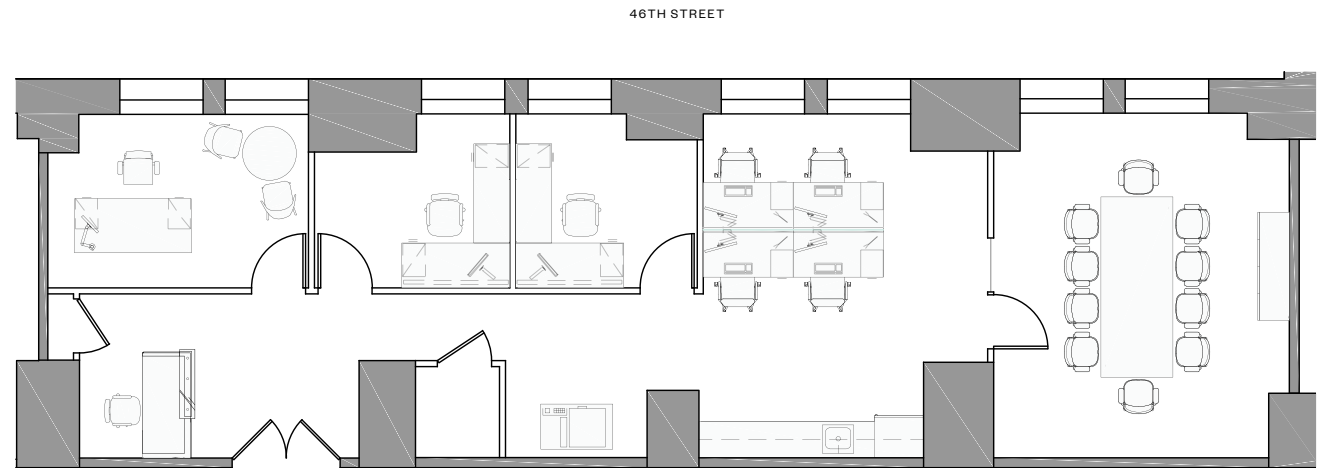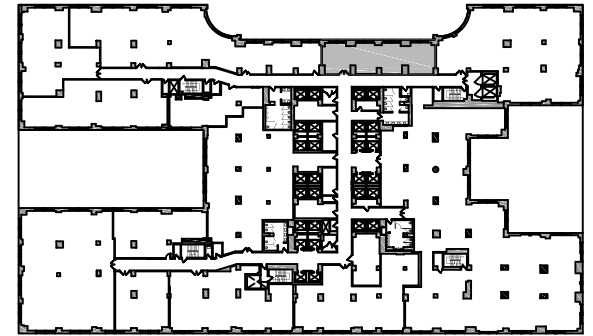

Jordan Berger
jberger@rxrrealty.com
646 891 3524

HelmsleyBuilding.com

